



Getsloff Design Group, Inc.
 15 Fishers Road, Suite 205
 Pittsford NY, 14534
 Tel: (585) 425-0932
 www.getsloffdesigngroup.com

GETSLOFF

DRAWING ALTERATION

IT IS A VIOLATION FOR ANY PERSON TO ALTER ANY ITEM ON THIS DOCUMENT IN ANY WAY WITHOUT THE WRITTEN RELEASE FROM GETSLOFF DESIGN GROUP.
 THESE DRAWINGS ARE THE PROPERTY OF GETSLOFF DESIGN GROUP AND ARE NOT TO BE USED, COPIED OR APPLIED WITHOUT WRITTEN CONSENT.

THE GETSLOFF DESIGN GROUP IS A FIRM OFFERING SERVICES IN SPACE PLANNING, PROJECT MANAGEMENT AND INTERIOR DESIGN. AND DOES NOT PRACTICE ARCHITECTURE OR ENGINEERING SERVICES. IT IS RECOMMENDED THAT A PROFESSIONAL LICENSED INDIVIDUAL BE CONSULTED IN THE ABOVE AREAS AS REQUIRED BY LAW.

REVISIONS

ISSUED FOR PERMIT
 ISSUED FOR CONST.

NO.	DATE	DESCRIPTION

PROJECT

**600
 CORNERSTONE
 CENTER**

LOCATION

2300 BUFFALO RD.
 BLDG. 600
 ROCHESTER, NEW YORK


DRAWING TITLE

CONCEPT FLOOR PLAN

SHEET NO.

ID-1

SCALE: AS NOTED
 DRAWN BY: CCC
 CHECKED BY: REG
 DATE: 2/4/22
 DRAWING: #5017

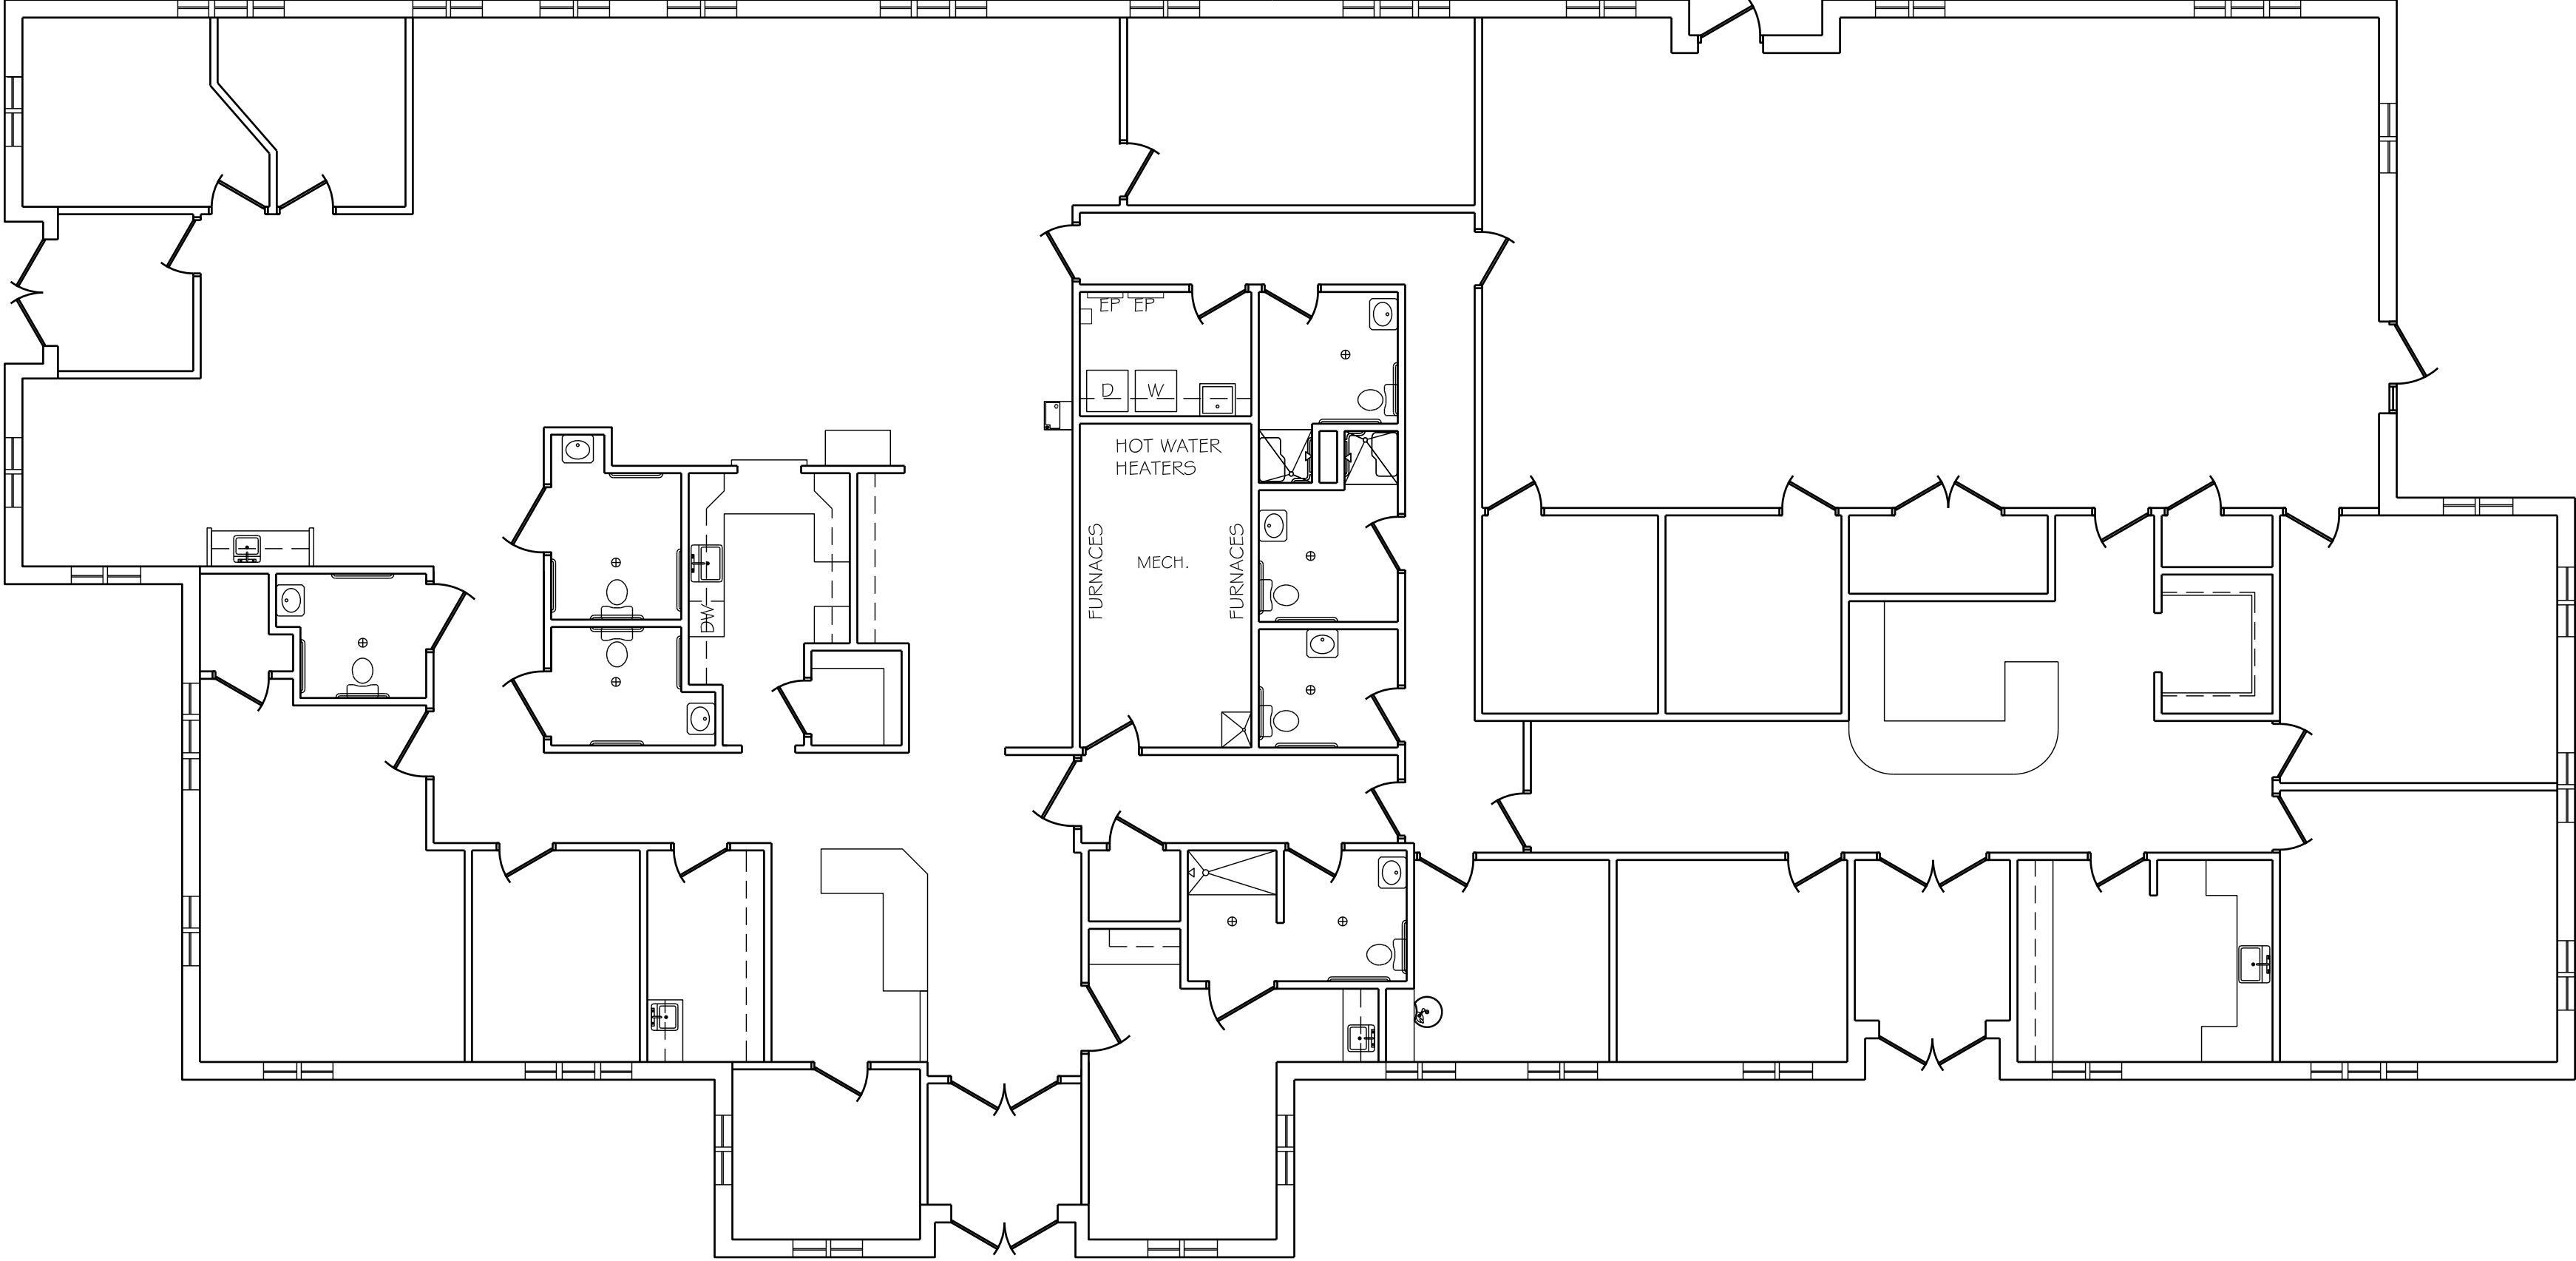

GENERAL NOTE:
 VERIFY DIMENSIONS & CONDITIONS IN THE FIELD PRIOR TO CONSTRUCTION OF THE INFORMATION SHOWN ON THIS DRAWING. & NOTIFY THE GETSLOFF DESIGN GROUP OF ANY DISCREPANCIES BETWEEN ACTUAL CONDITIONS AND THESE DRAWINGS.
 THESE DOCUMENTS ARE TO BE USED FOR INTERIOR BUILD-OUT ONLY. GETSLOFF DESIGN GROUP IS NOT RESPONSIBLE OR LIABLE FOR ANY STRUCTURAL, MECHANICAL, ELECTRICAL OR PLUMBING DESIGN/ENGINEERING. REFER TO ARCHITECTS' CODE COMPLIANT DRAWINGS FOR ANY ISSUES RELATING TO ADA OR LIFE-SAFETY WHICH MAY BE REQUIRED BY LOCAL OR STATE JURISDICTION.

**CONCEPT PLANS
 NOT FOR CONSTRUCTION
 ESTIMATING PURPOSES ONLY!**

ASSUMED AS-BUILT FLOOR PLAN

SCALE: 1/8" = 1'-0"

APPROVED: TENANT _____ DATE: _____

LANDLORD: _____ DATE: _____